

## DOKUMENTACE SKUTEČNÉHO PROVEDENÍ

Č.změny	Text změny - odůvodnění	Datum	Podpis



Olšanská 1a  
130 80 Praha 3  
Česká republika  
tel.: 224 22 71 68  
fax: 224 23 03 16  
faxmodem: 2670 943 64  
E-mail: praha@sudop.cz

OBJEDNATEL	Správa železniční dopravní cesty, s.o. a České dráhy a.s. v zastoupení: SŽDC s.o., Stavení správa Olomouc, Nerudova 1, 772 58 Olomouc		
STŘEDISKO	208 ELEKTROTECHNIKY, TRAKCE, SDĚLOVACÍ A ZABEZPEČOVACÍ TECHNIKY	VEDOUCÍ STŘEDISKA ING. MARTIN RAIBR	GENERÁLNÍ ŘEDITEL ING. JOSEF FIDLER
ODPOVĚDNÝ PROJEKTANT STAVBY	ODPOVĚDNÝ PROJ. OBJ., PS	NAVRHL, VYPRACOVAL	KONTROLOVAL
ING. MONIKA CHRENKOVÁ MCO a.s.	ING. PETR VEČEŘ <i>Petr Večeř</i>	ING. PETR VEČEŘ <i>Petr Večeř</i>	ING. KAREL KREMLÁČEK <i>Karel Kremláček</i>
KRAJ	OLOMOUCKÝ	MÚ/OÚ/POVĚŘENÁ OBEC	ŠUMPERK
Elektrizace trati Zábřeh - Šumperk PS 04-09-01 Žst. Šumperk, TM Šumperk, technologie - rozvaděč 22 kV		ÚČEL	DSP
		DATUM	04/2010
		MĚŘÍTKO	—
Obvodové schéma - rozvaděč 22 kV - vývod na usměr. sk. 2 TU2		FORMÁTY	A4
		ČÁST D.3.3	PŘÍL. 14






[illegible]

[illegible]

TU 2, TU 3, PLAZA VEŘEJNÁ TRÁVA V R 22KV

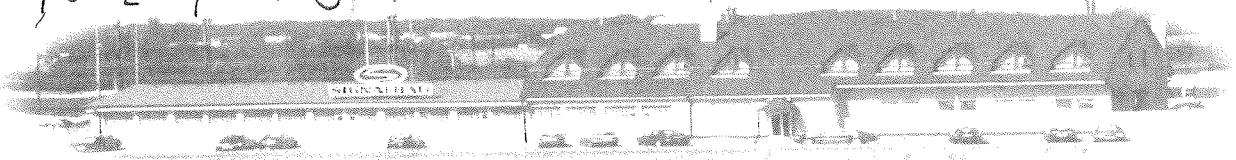

tel: 581 206 700 fax: 581 204 935  
IČ: 25840819 DIČ: CZ25840819

Moštěnská 60/4a, CZ-750 02 Přerov III - Lověšice

email: signalbau@signalbau.cz  
www.signalbau.cz

ALARM


TRIP-KAT.T.T.

PORUCHA  
SVIHAČE

T>

T>>


PWR

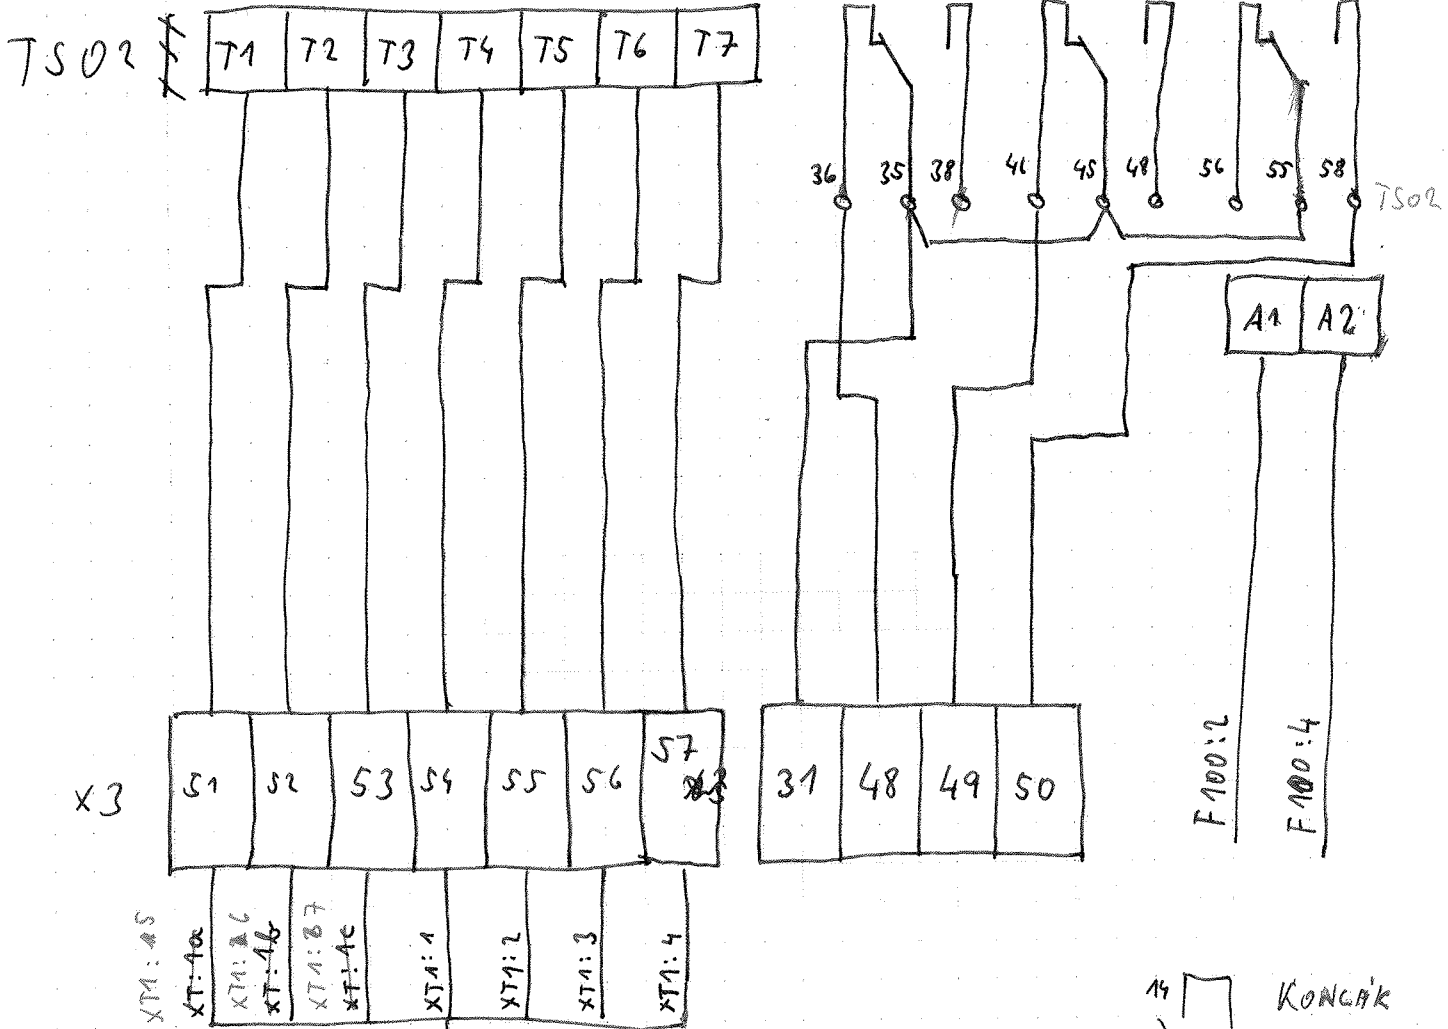

CYK 7A x 1,5

WS 120 - U2.2 R3LV/8

WS 122 U3.2 R3LV/1

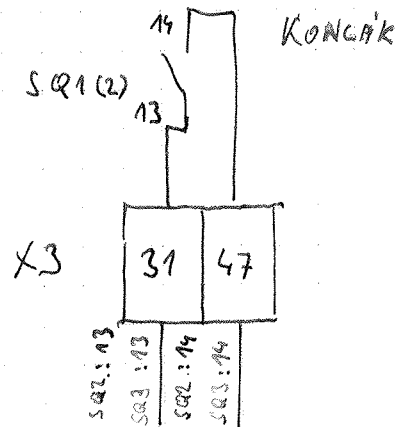

CYK 3A x 1,5

WS 125


WS 125



[illegible]




NO	DESCRIPTION	QTY	UNIT
1	F1	1	PC
2	F2	1	PC
3	F3	1	PC
4	T1	1	PC
5	T2	1	PC
6	T3	1	PC
7	S1	1	PC
8	S2	1	PC
9	S3	1	PC
10	X2.1	1	PC
11	X2.2	1	PC
12	X2.3	1	PC
13	X2.4	1	PC
14	X2.5	1	PC
15	X2.6	1	PC
16	X2.7	1	PC
17	X6.1	1	PC
18	X6.2	1	PC
19	W1.2	1	PC

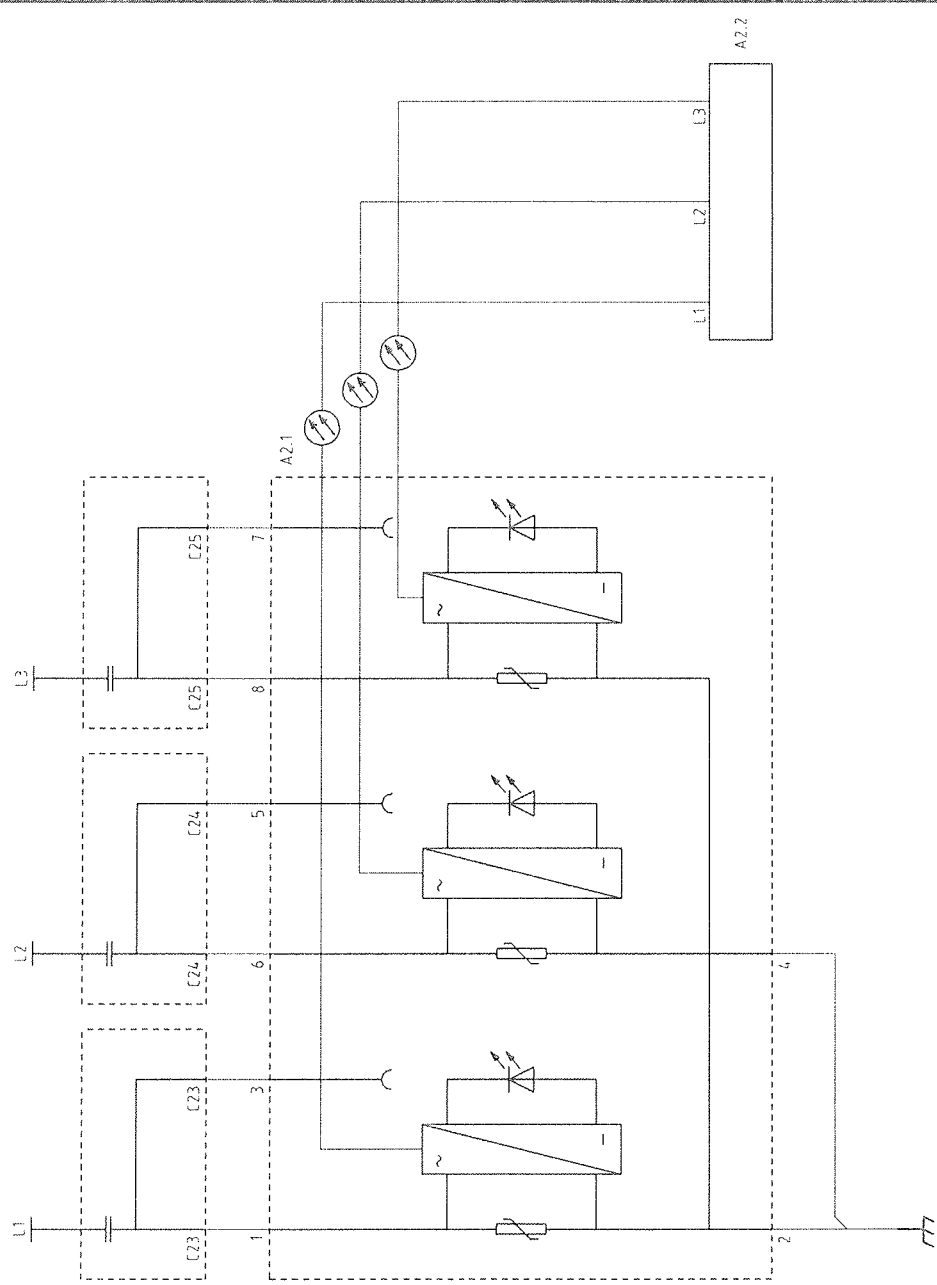

A2.2	NO	NC	CO
	/4,3	/4,4	/4,4

EASE EASING

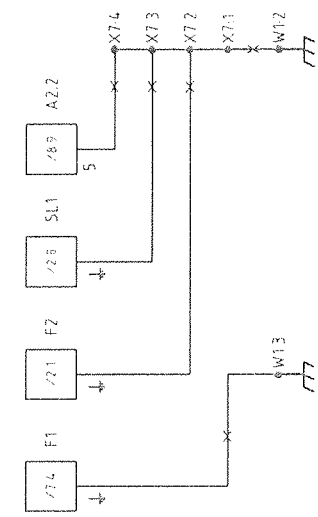

Project 30-201				Inst. Type: SVS-08				Project 30-201			
Rev description				date				Rev description			
by				date				by			
MP SUMPERK, SWITCHBOARD 22kV				Signalbau - Czech Republic				Signalbau - Czech Republic			
Circuit Diagram				Eaton   Holec				Eaton   Holec			
Ref				Ref				Ref			
Drawn 08.05.2009				Checked 08.05.2009				Drawn 08.05.2009			
LW				V. Thell				LW			
Drawing nr				R3-C-304201 X				Drawing nr			
Sheet 8				14. sh				Sheet 8			



0		1		2		3		4		5		6		7		8		9	
DESCRIPTION																			
CODE	DESCRIPTION																		
A2.1	LED VOLTAGE INDICATOR																		
A2.2	VOLTAGE INDICATOR INTERFACE WITH OPTICAL INPUTS																		
C23	CAPACITOR																		
C24	CAPACITOR																		
C25	CAPACITOR																		
F1	PROTECTION RELAY																		
F2	OVERVOLTAGE RELAY																		
F6	NO-VOLTAGE RELEASE COIL MEASURINGSET																		
F100	MINIATURE CIRCUIT-BREAKER																		
F101	MINIATURE CIRCUIT-BREAKER																		
F102	MINIATURE CIRCUIT-BREAKER																		
F103	MINIATURE CIRCUIT-BREAKER																		
F105	MINIATURE CIRCUIT-BREAKER																		
F106	MINIATURE CIRCUIT-BREAKER																		
K1	AUXILIARY RELAY																		
K2	AUXILIARY RELAY																		
K6	AUXILIARY RELAY																		
K11	AUXILIARY RELAY																		
M1.1	SPRING-CHARGING AND CLOSING MOTOR																		
M1.2	AUXILIARY CONTACTS SPRING CHARGING MOTOR																		
	11-12: 21-22 CLOSED ONLY WHEN SPRING IS CHARGED																		
	13-14, 23-24 OPENED ONLY WHEN SPRING IS CHARGED																		
Q1	CIRCUIT-BREAKER																		
	AUXILIARY CONTACTS CIRCUIT-BREAKER																		
	11-12, 21-22, ... CLOSED ONLY WHEN THE CIRCUIT-BREAKER IS OPEN																		
	13-14, 23-24, ... CLOSED ONLY WHEN THE CIRCUIT-BREAKER IS CLOSED																		
Q2	CHANGEOVER SWITCH																		
	AUXILIARY CONTACTS CHANGEOVER SWITCH																		
	11-12, 21-22 OPENED ONLY IN THE EARTHING POSITION																		
	13-14, 23-24 CLOSED ONLY IN THE EARTHING POSITION																		
	51-52; 61-62 CLOSED ONLY IN THE OPERATING POSITION																		
	53-54, 63-64 OPENED ONLY IN THE OPERATING POSITION																		
S0	PUSH-BUTTON "OFF" (WHITE)																		
S1	PUSH-BUTTON "ON" (GREEN) - PADLOCKABLE																		
S2	AUXILIARY CONTACT CONTROLLED BY THE EARTHING LOCK																		
	11-12 OPENED ONLY WHEN THE CIRCUIT-BREAKER IS USED FOR EARTHING																		
	AND IS LOCKED BY KEY																		
CODE DESCRIPTION																			
Project: 304201																			
Inst. type: SVS-06																			
MR SUMPERK, SWITCHBOARD 22kV																			
SIGNALBAU - CZECH REPUBLIC																			
rev description date by																			
19.06.2009 IG																			
drawing nr																			
sheet 10																			
R3-C-304201 X																			
A																			
14 sh																			
Register:																			

		0	1	2	3	4	5	6	7	8	9
		DESCRIPTION						TYPE	ART NR	CIRCUIT NR	UNIT WIRING DIAGRAM
S4		AUXILIARY CONTACT CONTROLLED BY THE SELECTOR 11-12 CLOSED ONLY WHEN THE SELECTOR IS IN THE LEFT POSITION 13-14 OPENED ONLY WHEN THE SELECTOR IS IN THE LEFT POSITION						S 800 E/20	E313196	/3.3	
SA1		SELECTOR SWITCH						CHR10-4		/5.7	R3-C-304201 1/6
SL1		ETHERNET SWITCH						RUGGEDCOM		/2.8	
T1		CURRENT TRANSFORMER						CTS		/1.3	
T2		CURRENT TRANSFORMER						CTS		/1.3	
T3		CURRENT TRANSFORMER						CTS		/1.3	
W1		EARTH CONNECTION									
X0		TERMINAL STRIP						UK5-TWIN		/12.1	
X1		TERMINAL STRIP						UK5-TWIN		/12.4	
X2		TERMINAL STRIP						UGSK 6		/13.1	
X3		TERMINAL STRIP						UK5-TWIN		/13.2	
X6		EARTH STRIP									
X7		EARTH STRIP									
FX1		TERMINAL STRIP						PHOENIX		/14.1	
Y1		TRIP COIL						KENDRION	E310592	/1.3	
Y5		LOCKING COIL ON OPERATING SHAFT OF THE CIRCUIT-BREAKER MECHANICAL CLOSING OF THE CIRCUIT-BREAKER IS ONLY POSSIBLE WITH ENERGISED COIL						KENDRION	DBMX604.0 01.N010, 0.14A, 110V DC	/1.0	
Y6		NO-VOLTAGE RELEASE COIL						INTROCOM	2.5/0.077A, 110V DC	/1.2	
		Project 304201						drawing nr		sheet 11	
		Inst. type: SVS-08						L W		R3-C-304201 X	
								V THEL			
								DE JONG			
								Ref.		Ref.	
								Ref.		Ref.	
								Ref			

0		1		2		3		4		5		6		7		8		9	
REMOTE END DESIGNATION		CABLE NO. AND NO. OF CORES																	
REMOTE END DESIGNATION		CABLE NO. AND NO. OF CORES																	
[illegible]

0		1		2		3		4		5		6		7		8		9	
REMOTE END DESIGNATION		CABLE NO. AND NO. OF CORES		<div>TERMINAL STRIP X2</div>		<div>1 2 3 4 5 6 7</div>		<div>1 2 3 4 5 6 7</div>		<div>1 2 3 4 5 6 7</div>		<div>1 2 3 4 5 6 7</div>		<div>1 2 3 4 5 6 7</div>		<div>1 2 3 4 5 6 7</div>		<div>1 2 3 4 5 6 7</div>	
REMOTE END DESIGNATION		CABLE NO. AND NO. OF CORES		X6 - 2		T1 - S1		T1 - S2		T2 - S1		T2 - S2		T3 - S1		T3 - S2		X6 - 2	
REMOTE END DESIGNATION		CABLE NO. AND NO. OF CORES		X3		1 2 3 4 5 6 7		1 2 3 4 5 6 7		1 2 3 4 5 6 7		1 2 3 4 5 6 7		1 2 3 4 5 6 7		1 2 3 4 5 6 7		1 2 3 4 5 6 7	
REMOTE END DESIGNATION		CABLE NO. AND NO. OF CORES		X3		1 2 3 4 5 6 7		1 2 3 4 5 6 7		1 2 3 4 5 6 7		1 2 3 4 5 6 7		1 2 3 4 5 6 7		1 2 3 4 5 6 7		1 2 3 4 5 6 7	
REMOTE END DESIGNATION		CABLE NO. AND NO. OF CORES		X3		1 2 3 4 5 6 7		1 2 3 4 5 6 7		1 2 3 4 5 6 7		1 2 3 4 5 6 7		1 2					

[illegible]

